


APPROVED AS NOTED

JUL 15 1993
LAKE OF THE WOODS
Environmental Control Committee

By *[Signature]*
[Signature]

LAKE

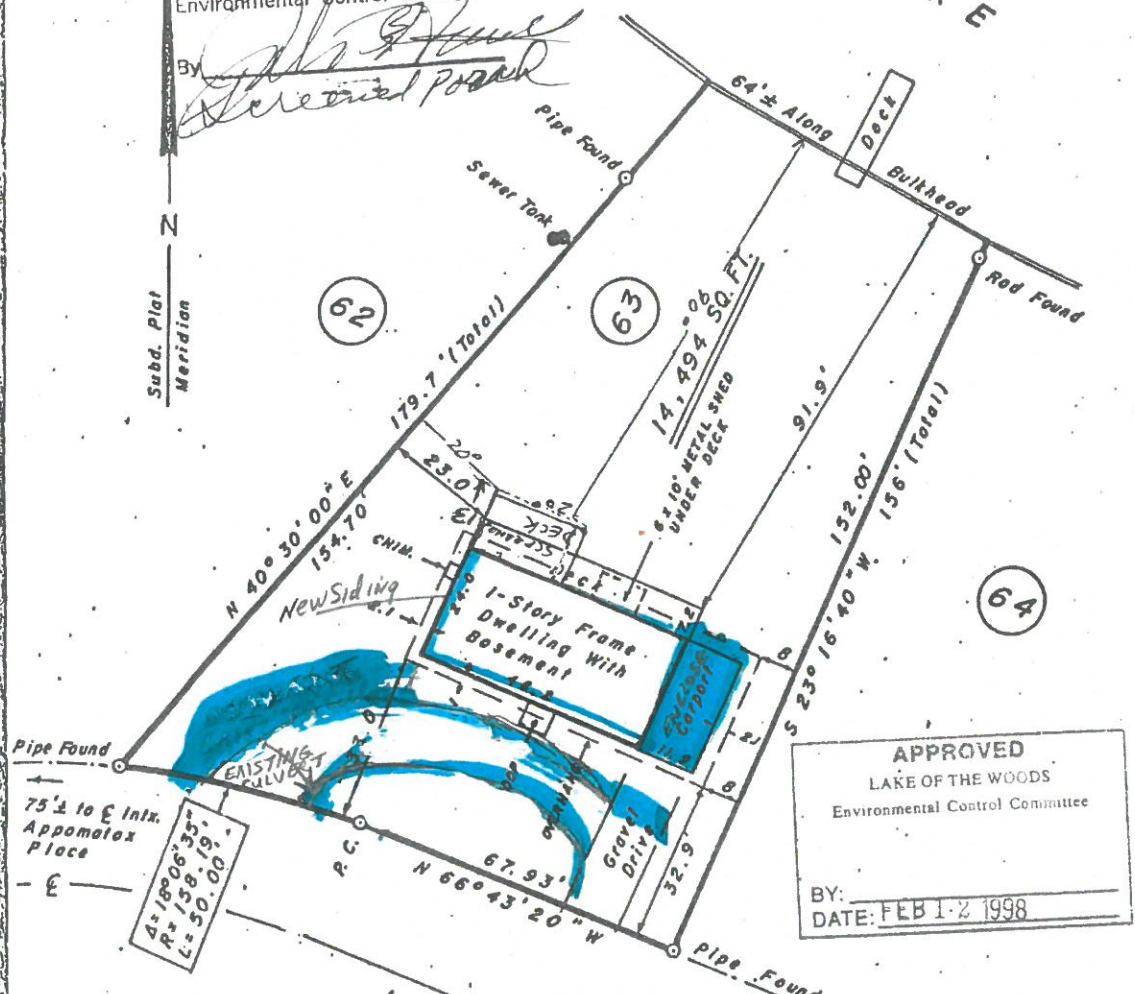

APPROVED
LAKE OF THE WOODS
Environmental Control Committee

BY:
DATE: FEB 12 1998

[Signature]
8/19/88

LEE CIRCLE
(50' R/W)

APPROVED AS NOTED

LAKE OF THE WOODS
Environmental Control Committee

[Signature]
OCT 6 1988

NOTES:

1. No Title Report has been furnished.
2. This plat does not necessarily indicate all easements or encumbrances on the property.
3. Underground utilities or subsurface facilities not located.
4. Lot subject to utility easements 5' wide on rear and side property lines and 10' wide on front property line.
5. Parcel shown is not in a HUD Flood Hazard Zone.
6. Dwelling located at 108 Lee Circle.

Physical Survey
LOT 63, SECTION 4
Lake Of The Woods Subdivision
Orange County, Virginia

Prepared By
HERNDON and GRYMES
LAND SURVEYORS
ORANGE, VIRGINIA

Scale: 1" = 30' Job 88176
Date: August 19, 1988